





Filename: chan\_det

A4

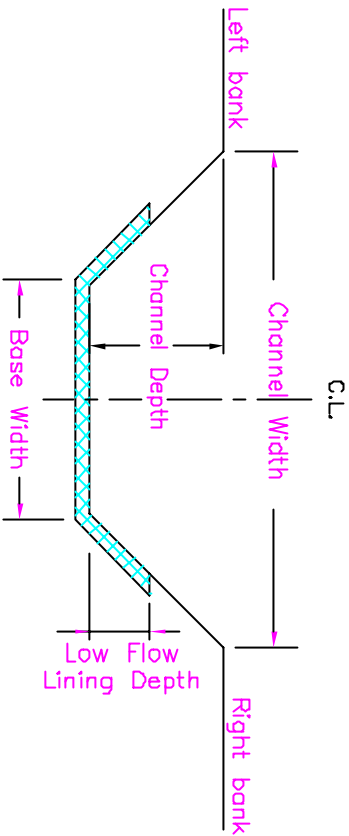

TRAPEZOIDAL CHANNEL  
WITH LOW FLOW LINING

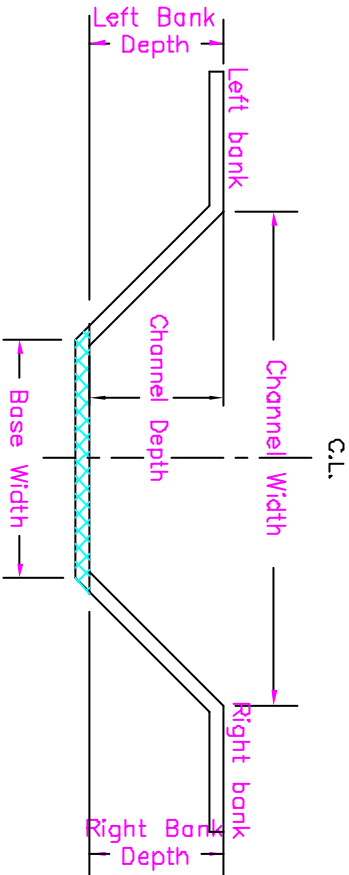

TRAPEZOIDAL CHANNEL



CHANNEL

NOTE:  
This drawings is to show  
where measurements should  
to be taken and is NOT a  
requirement for as built  
submission.

- NOTE
1. Typical information required for all channel types.
  2. Where channel change direction between node point record x,y, coordinates at centre of channel.

SAMPLE ONLY

STORMWATER AS-BUILT PLAN  
REQUIRED INFORMATION FOR  
STORMWATER CHANNELS